

**ATTACHMENT "7"**  
**LEASE AND DEVELOPMENT OF VACANT LAND FOR COMMERCIAL USES**  
**(RFP #PB 17-3)**


**Utility Maps/Structure Height Information**

# P.B.C.W.U.D. Water Distribution Map Map Grid: D20NE


### Legend

	As-Built No.		Valve Public
	Hydrant No.		Valve Private
	Valve No.		Air Release Valve
	A.R.V. No.		Back Flow Valve
	W.M. Public		Reducer
	W.M. Private		Meter
	Hydrant Line		Display Grid
	Fire Line		Parcels
	Hydrant Public		Canals
	Hydrant Private		Not PBCWUDSA (No Aerial)

### Zone 1 - Location Map

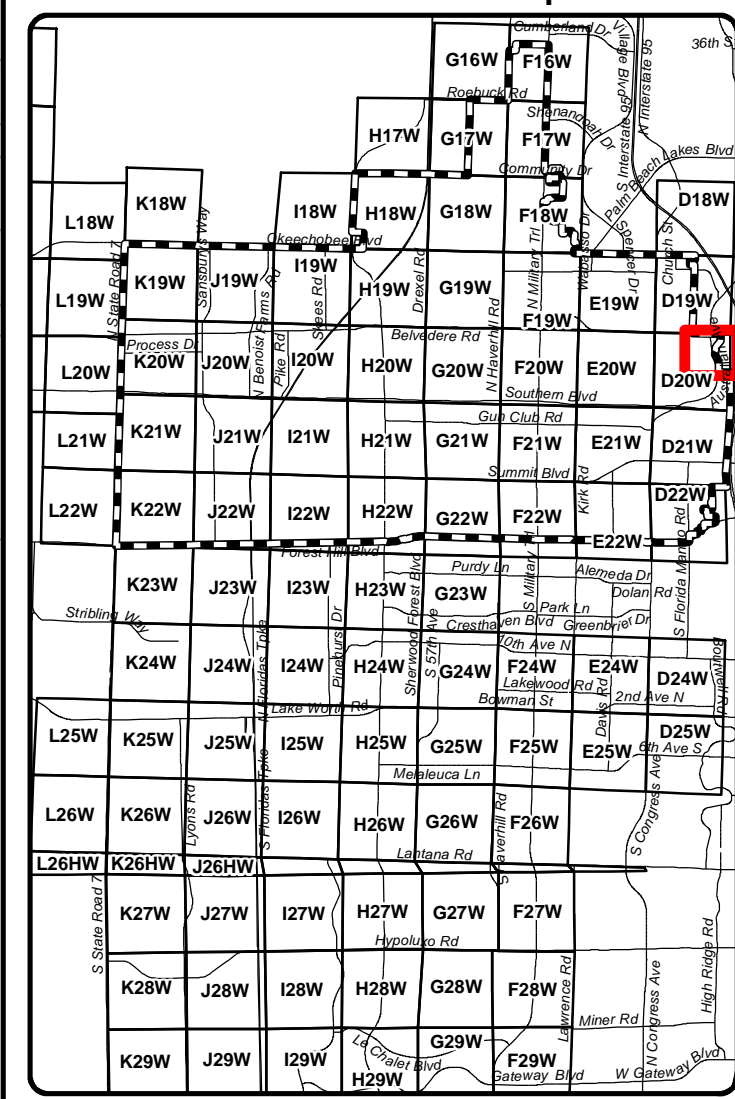

RangeTownshipSection: **434332**

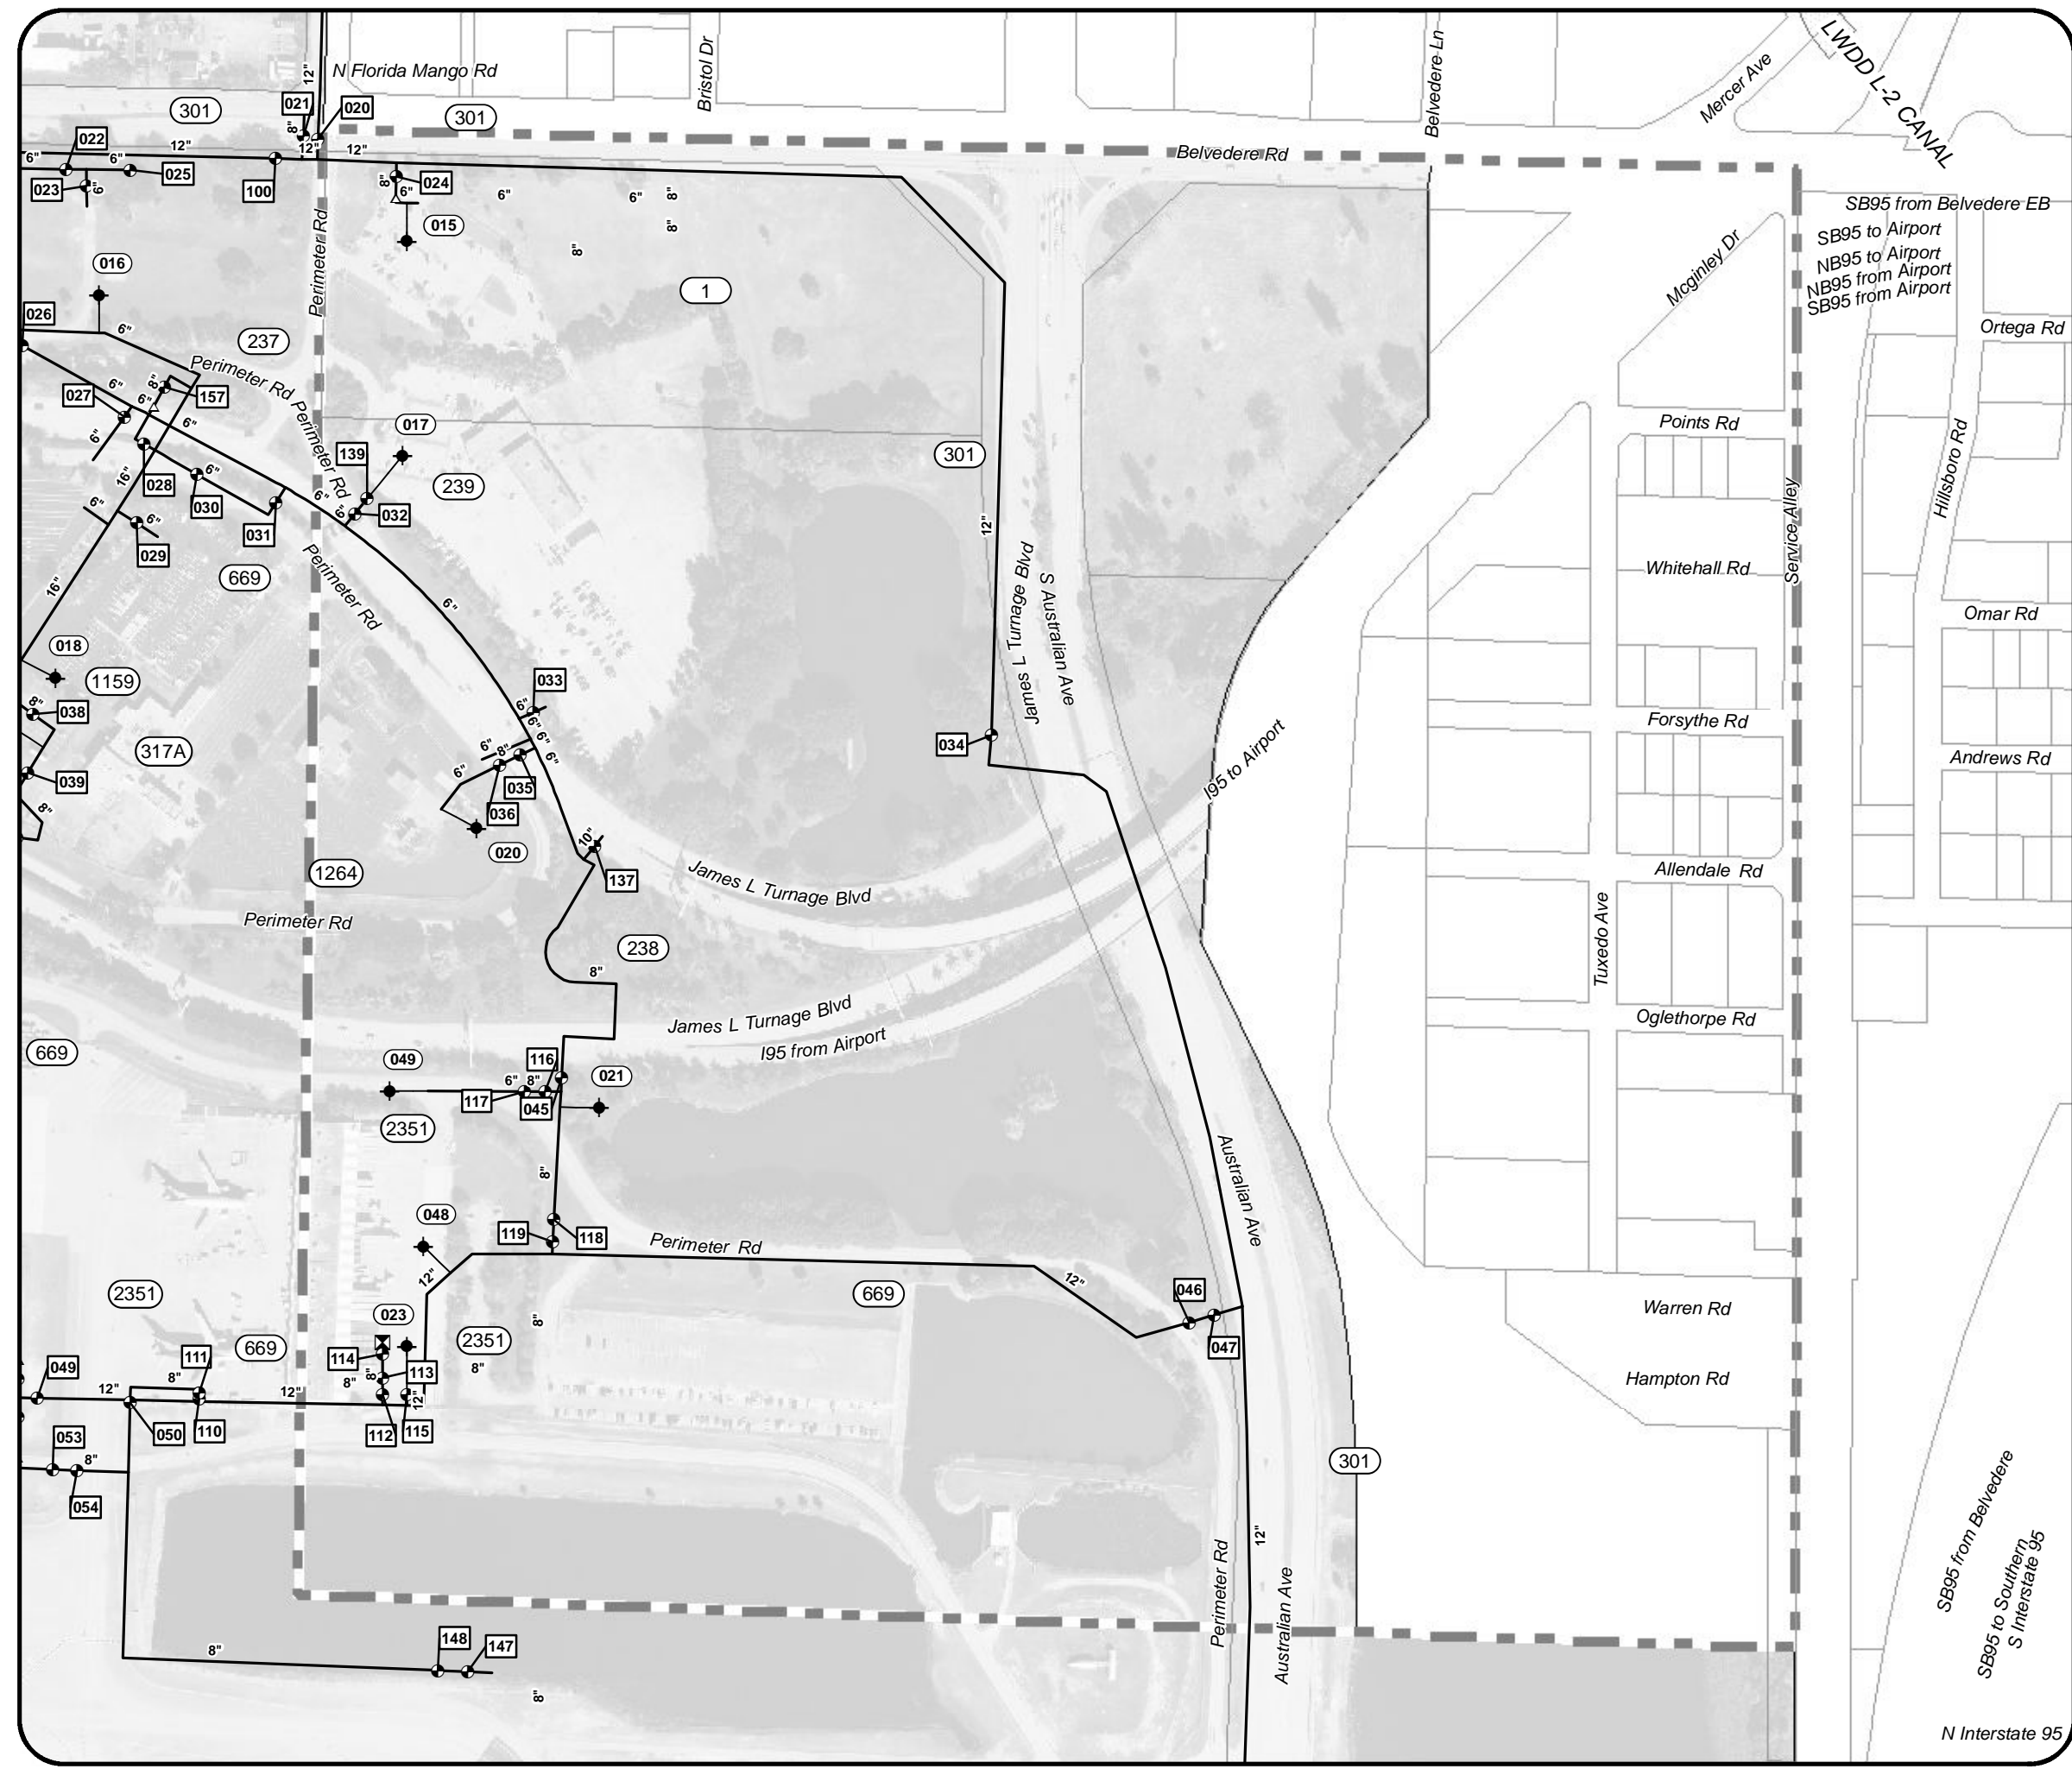


# P.B.C.W.U.D. Wastewater Collection Map Map Grid: D20NES


### Legend

As-Built No.	Valve Public
Manhole No.	Valve Private
Valve No.	AirRelease Valve
A.R.V. No.	Reducer
F.M. Public	L.S. Public
F.M. Private	L.S. Private
G.M. Public	Display Grid
G.M. Private	Parcels
Manhole Public	Canals
Manhole Private	Not PBCWUDSA (No Aerial)

### Zone 1 - Location Map

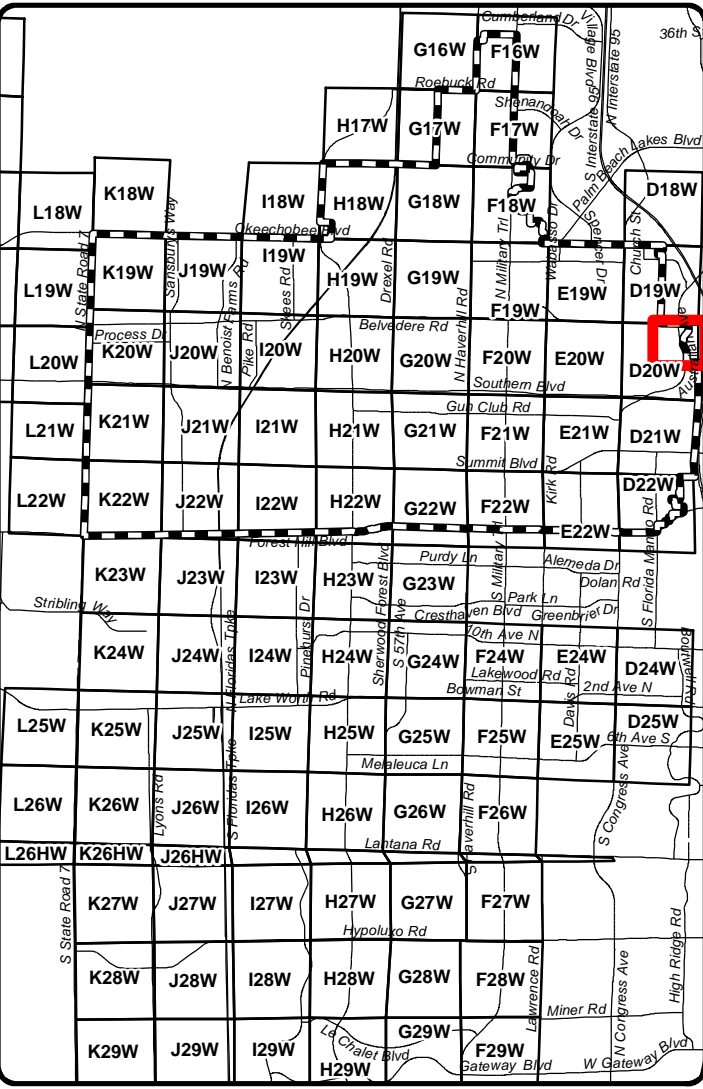

RangeTownshipSection: **434332**

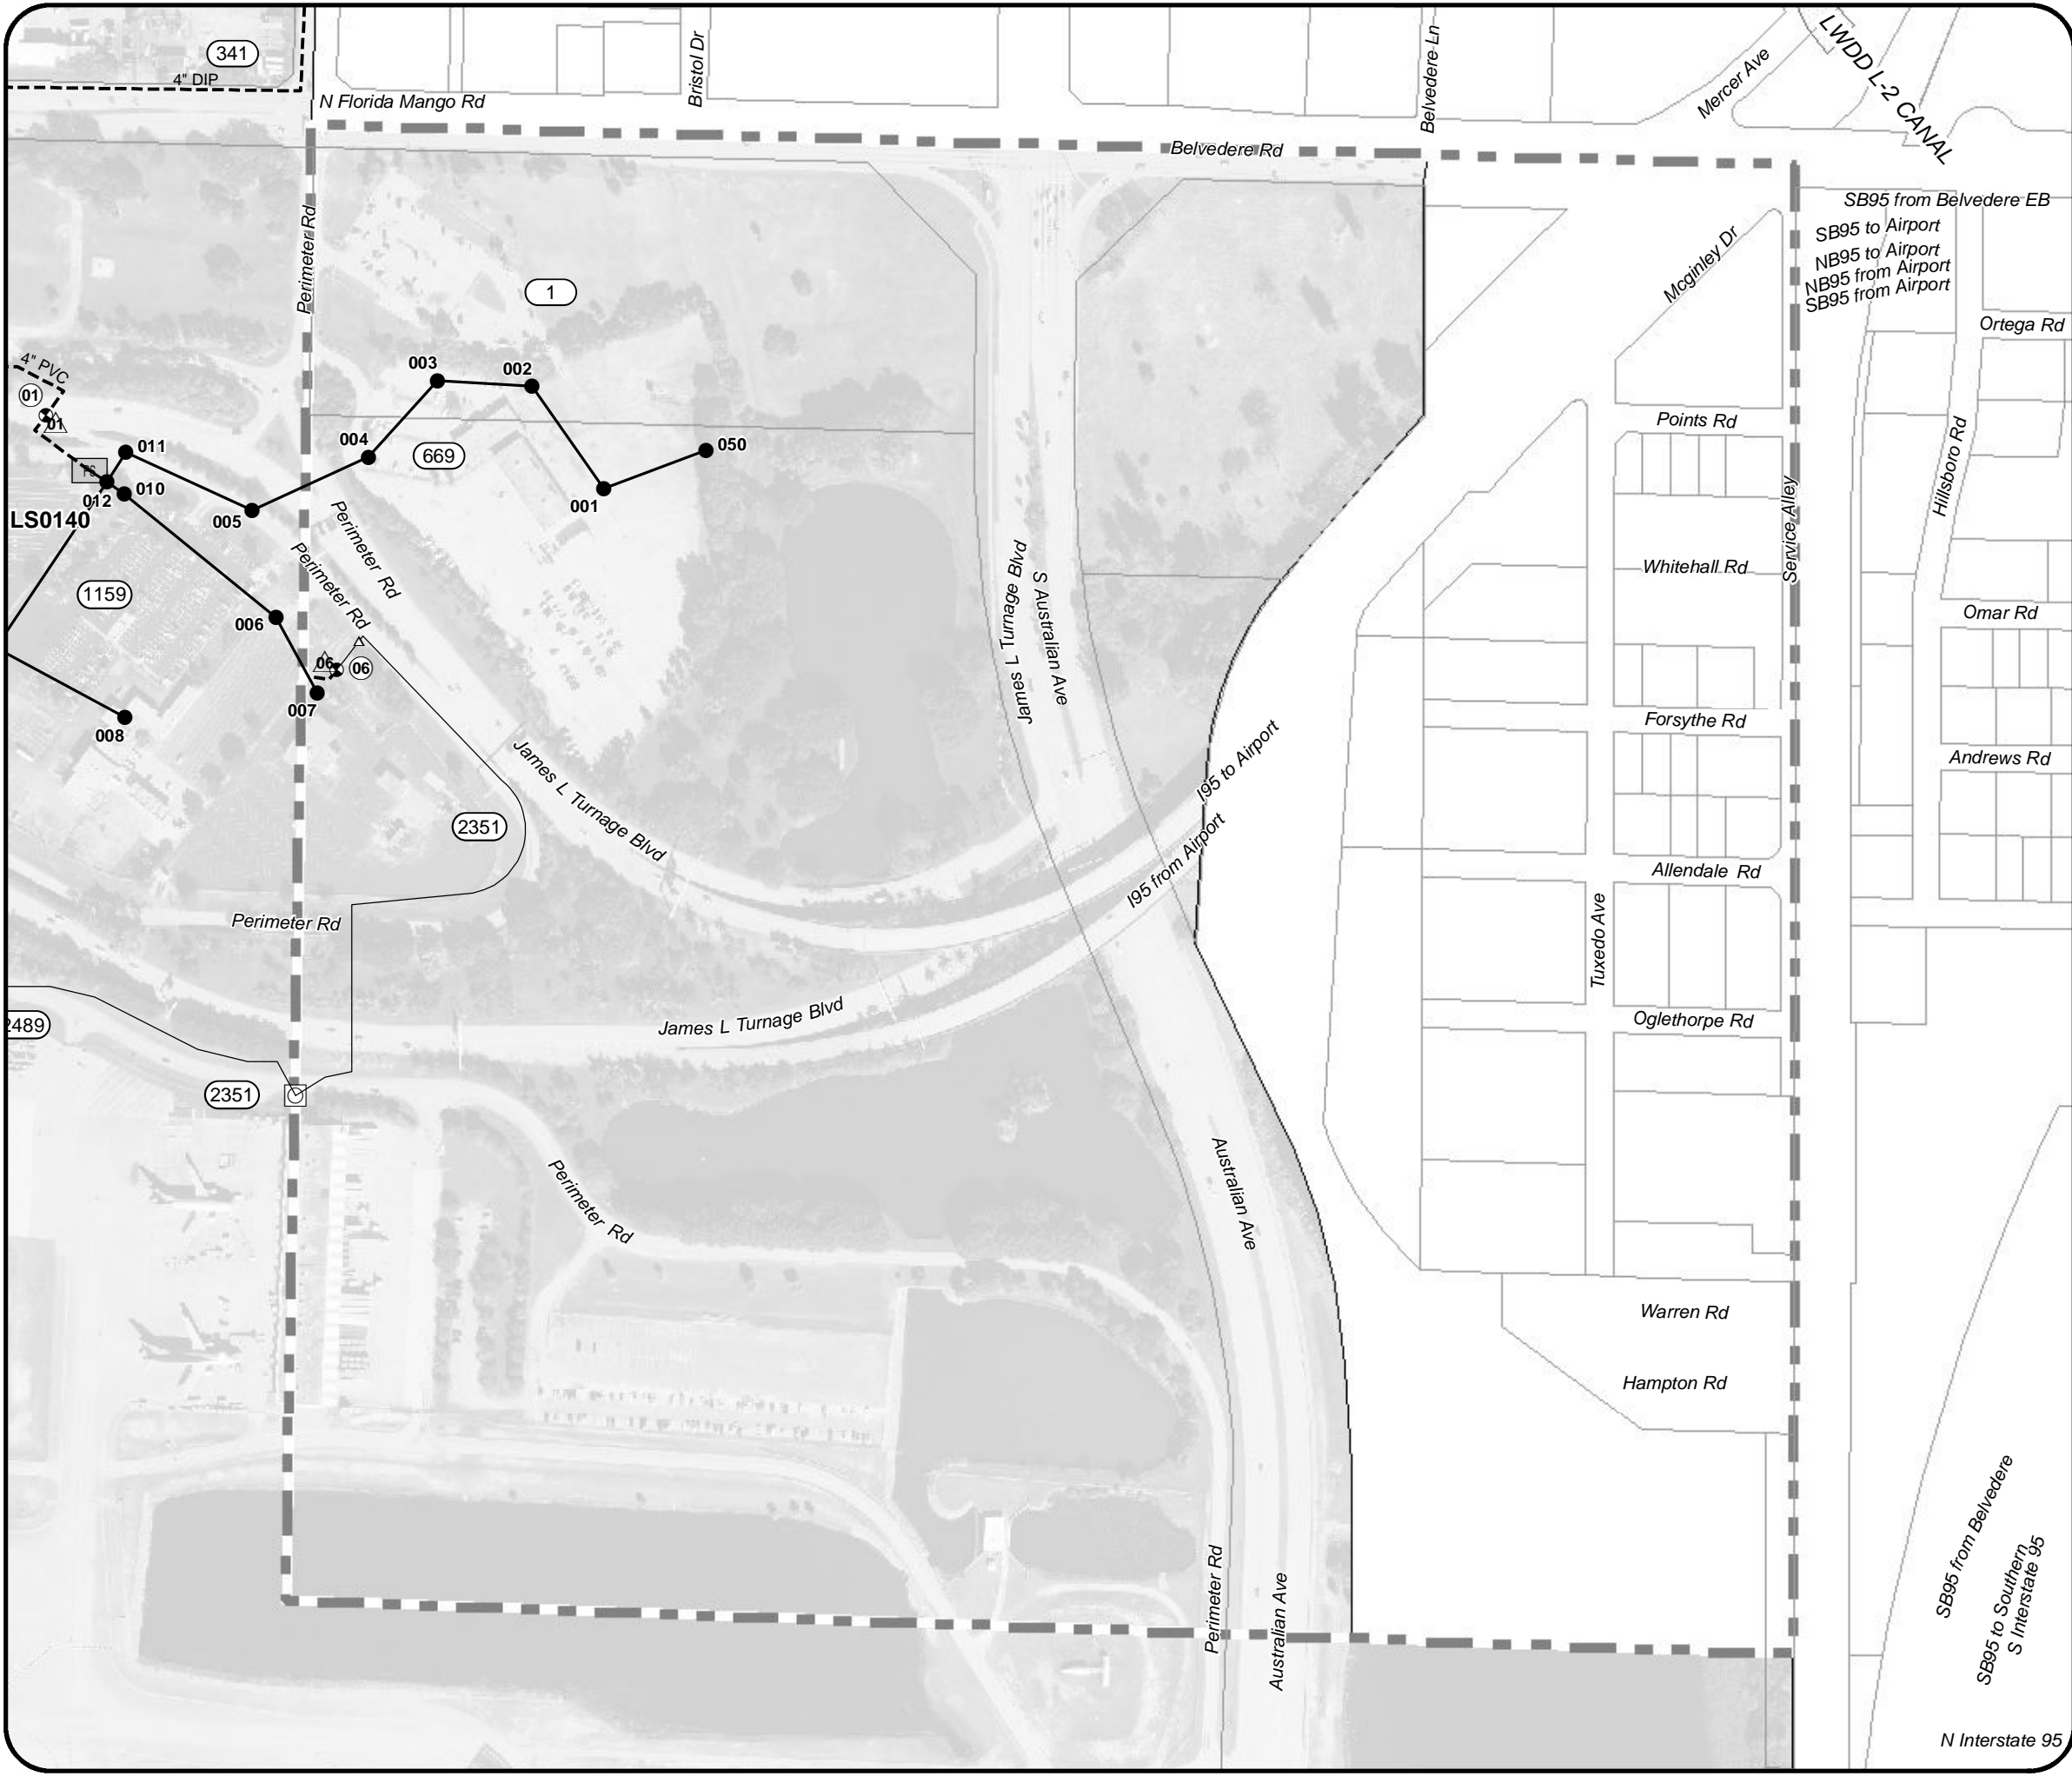

1 inch = 300 feet

NOTE: This item is exempt from public disclosure under Florida Statutes, Chapter 119. The document may only be used by you and your organization in the performance of your duties and may not be disseminated to any other party without the consent of Palm Beach County. This map is not official and is for presentation purposes only. For as-built locations, see record drawings on file at P.B.C.W.U.D.


	P.B.C. Water Utilities Department 8100 Forest Hill Blvd. West Palm Beach, Florida 33416 Phone: (561) 493-6000	Contact: Bill Kramer / Danny Thorpe File Name: W:\GIS\MAPS\Grid_Maps\ Grid map mxd files\WUD-Sewer-Mile.mxd Map Created: May 31, 2012	
--	------------------------------------------------------------------------------------------------------------------------	------------------------------------------------------------------------------------------------------------------------------------------------	--

Date Printed: 5/12/2015


# P.B.C.W.U.D. Water Distribution Map Map Grid: D20NW

### Legend

As-Built No.	Valve Public
Hydrant No.	Valve Private
Valve No.	Air Release Valve
A.R.V. No.	Back Flow Valve
W.M. Public	Reducer
W.M. Private	Meter
Hydrant Line	Display Grid
Fire Line	Parcels
Hydrant Public	Canals
Hydrant Private	Not PBCWUDSA (No Aerial)

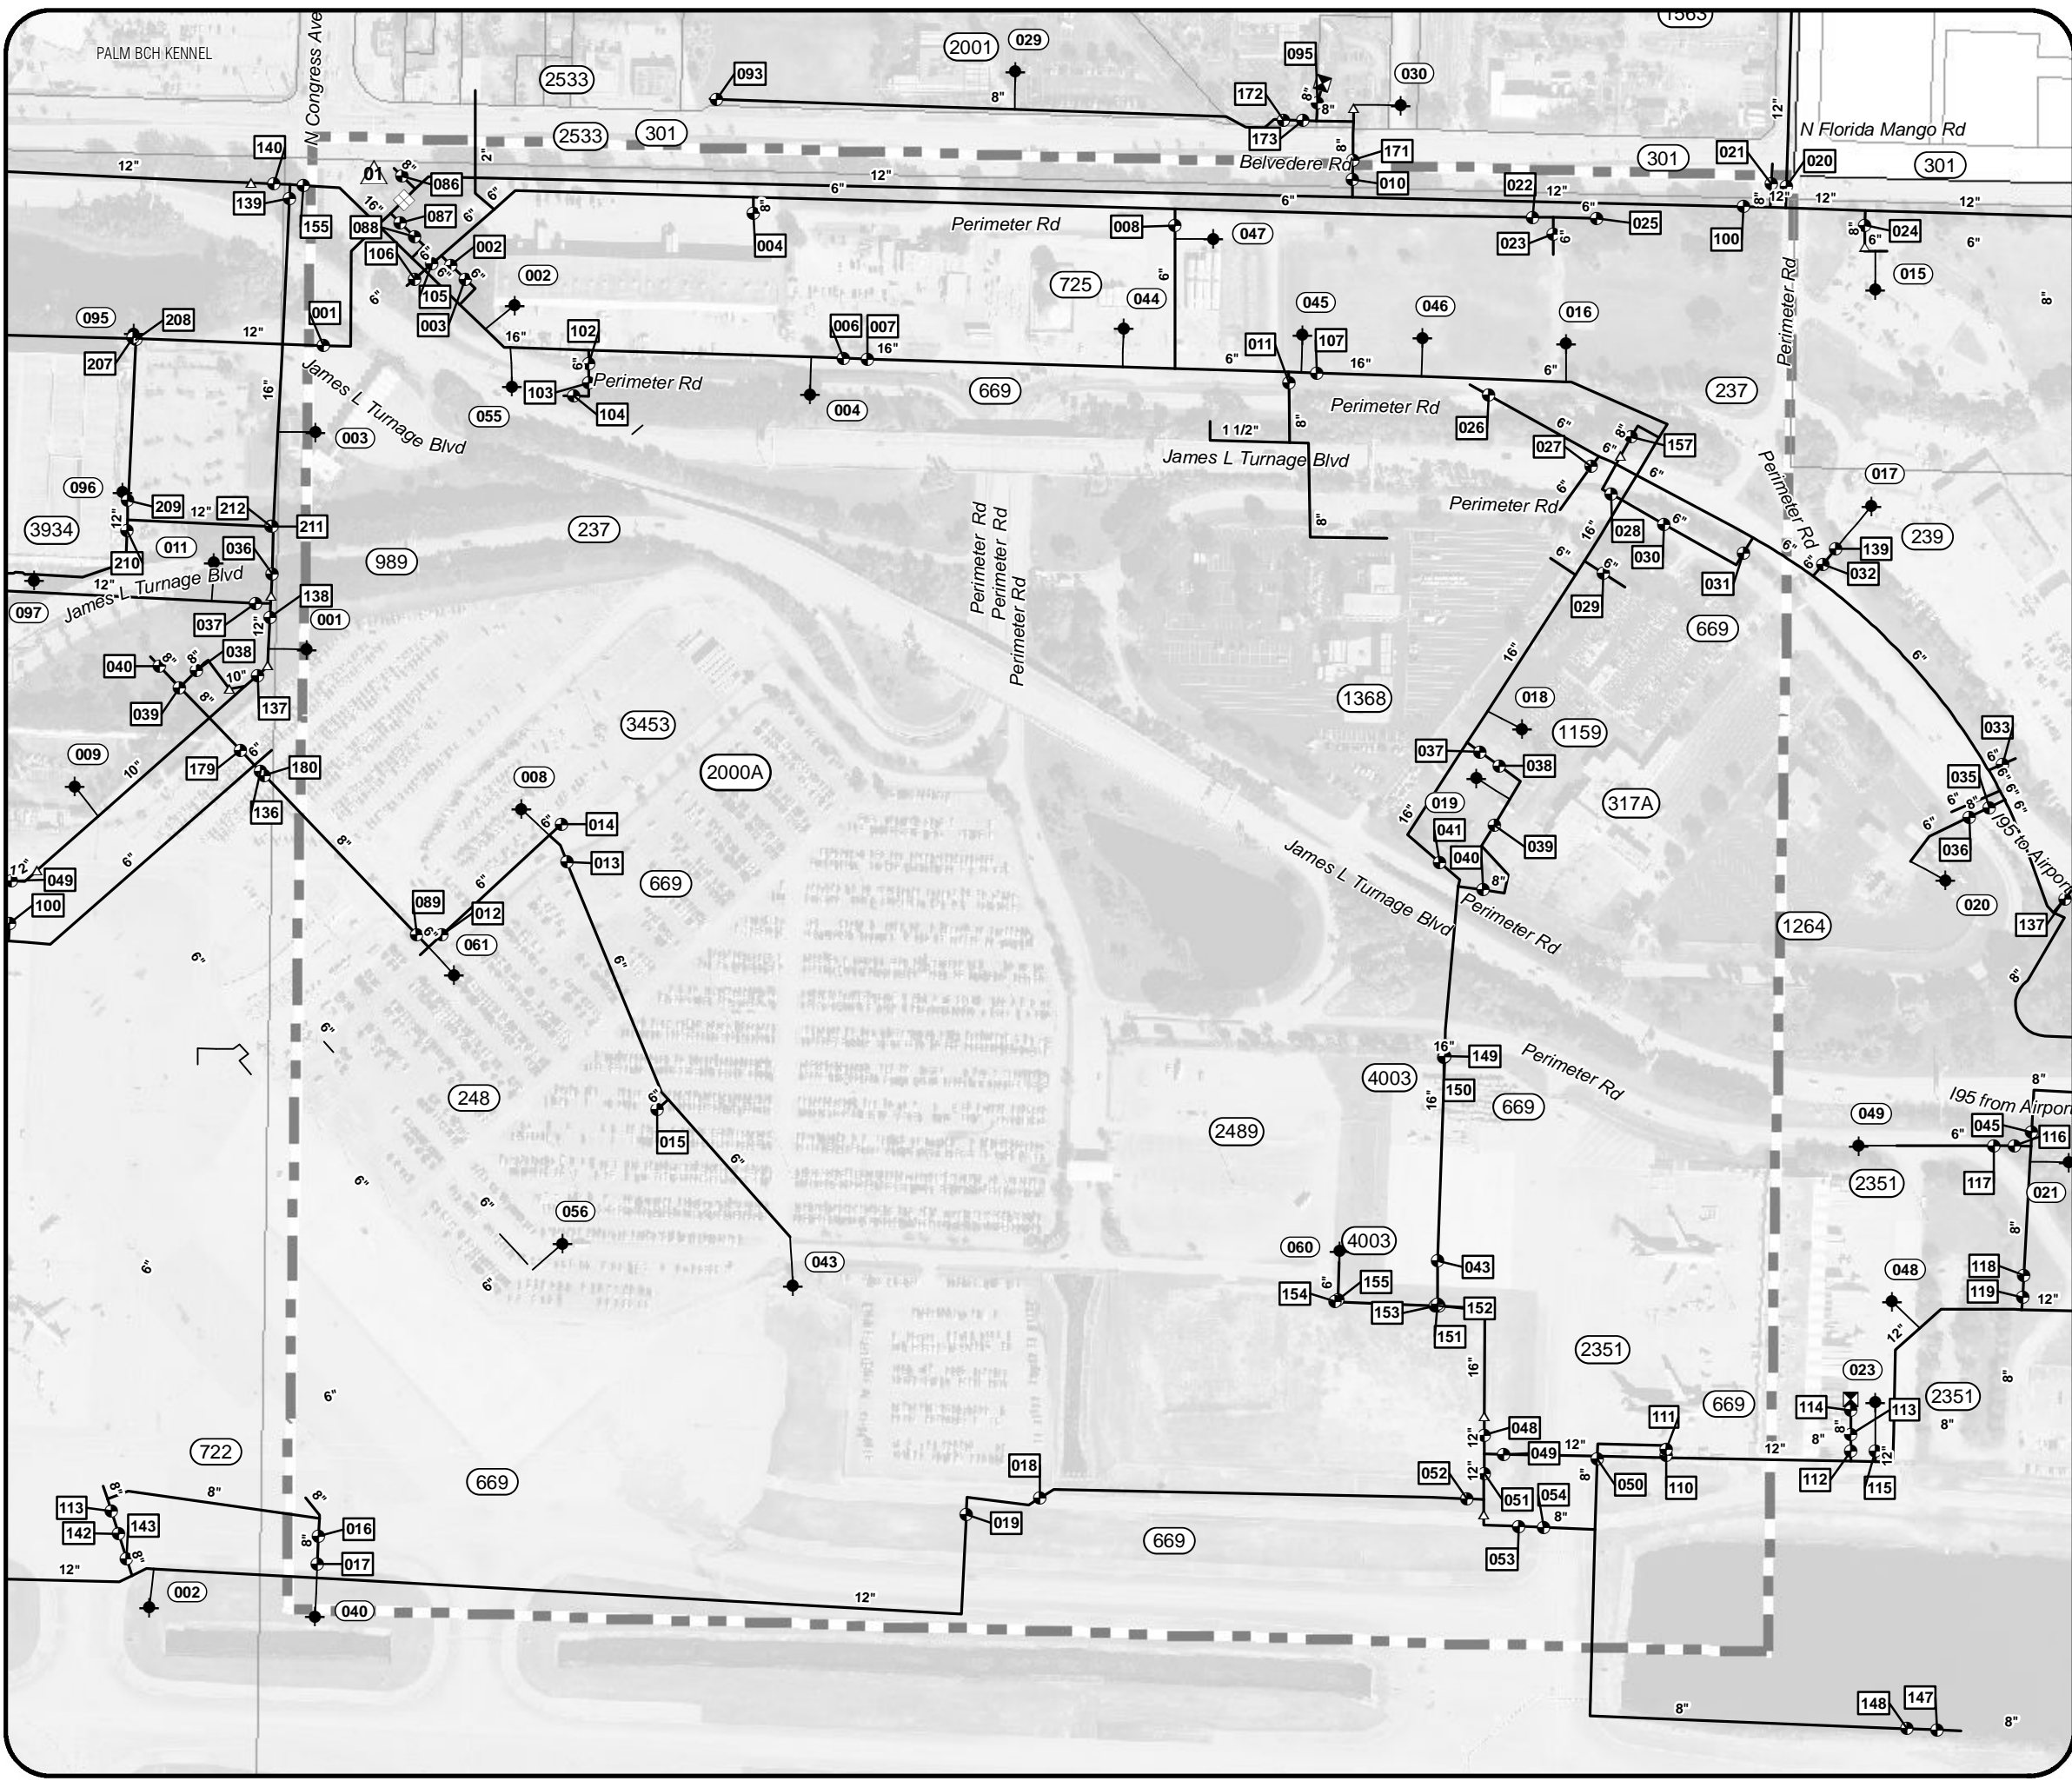

### Zone 1 - Location Map

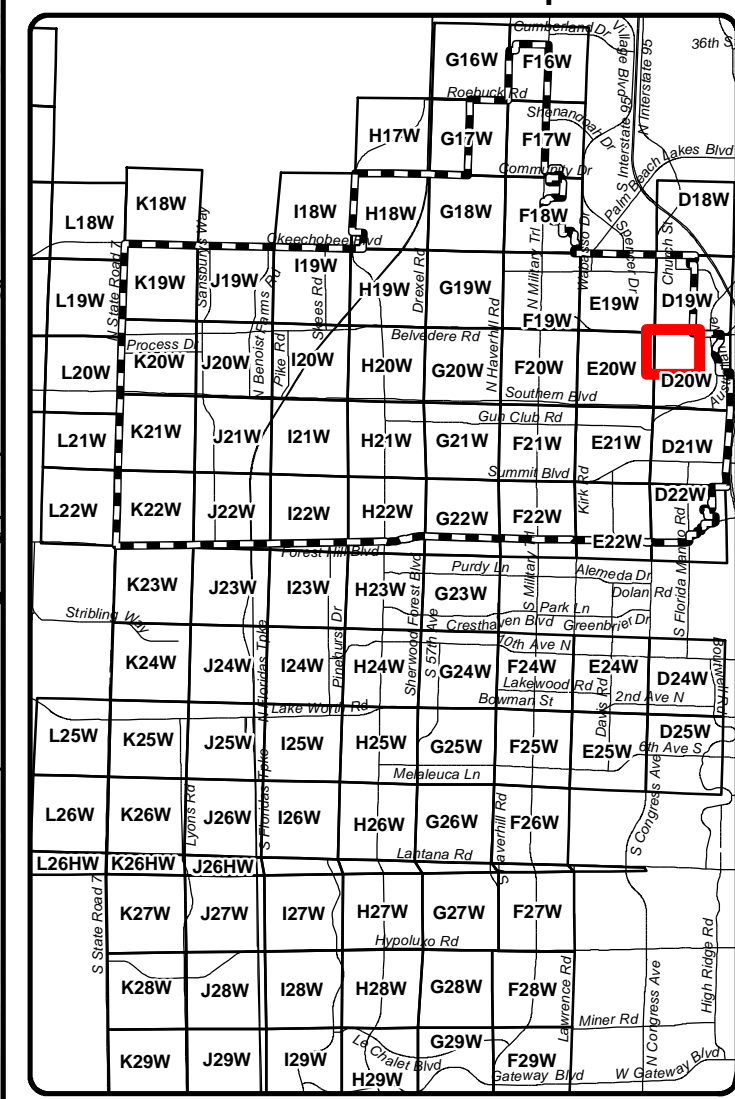


RangeTownshipSection: **434332**

# P.B.C.W.U.D. Wastewater Collection Map Map Grid: D20NWS


### Legend

As-Built No.	Valve Public
Manhole No.	Valve Private
Valve No.	AirRelease Valve
A.R.V. No.	Reducer
F.M. Public	L.S. Public
F.M. Private	L.S. Private
G.M. Public	Display Grid
G.M. Private	Parcels
Manhole Public	Canals
Manhole Private	Not PBCWUDSA (No Aerial)

### Zone 1 - Location Map

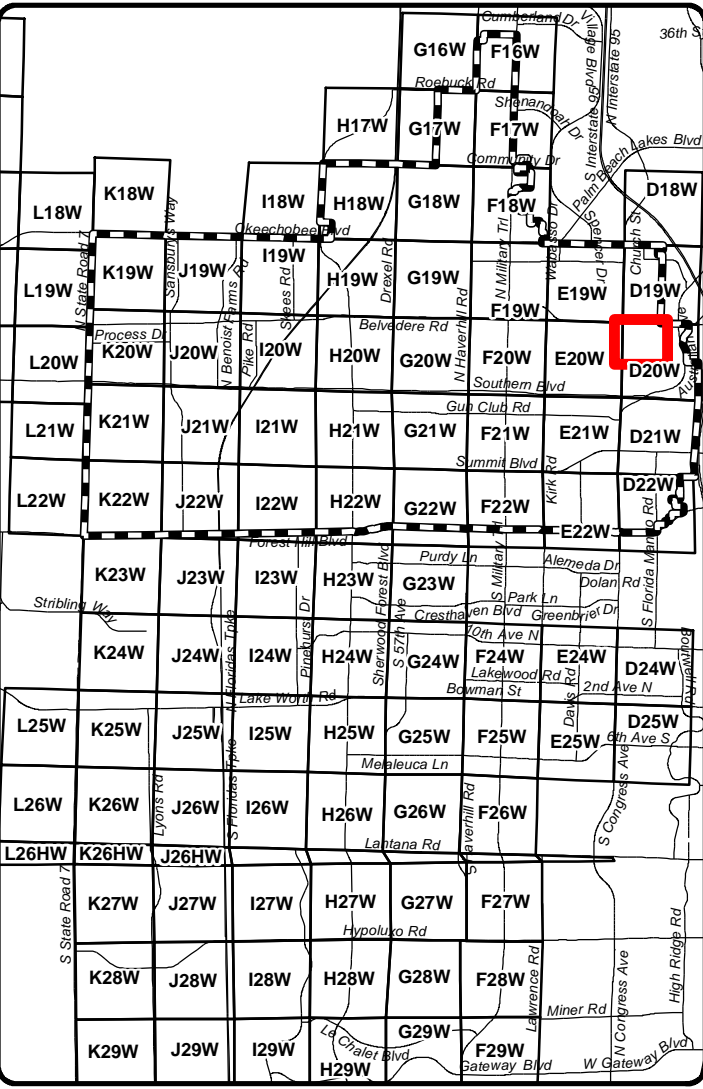

RangeTownshipSection: **434332**

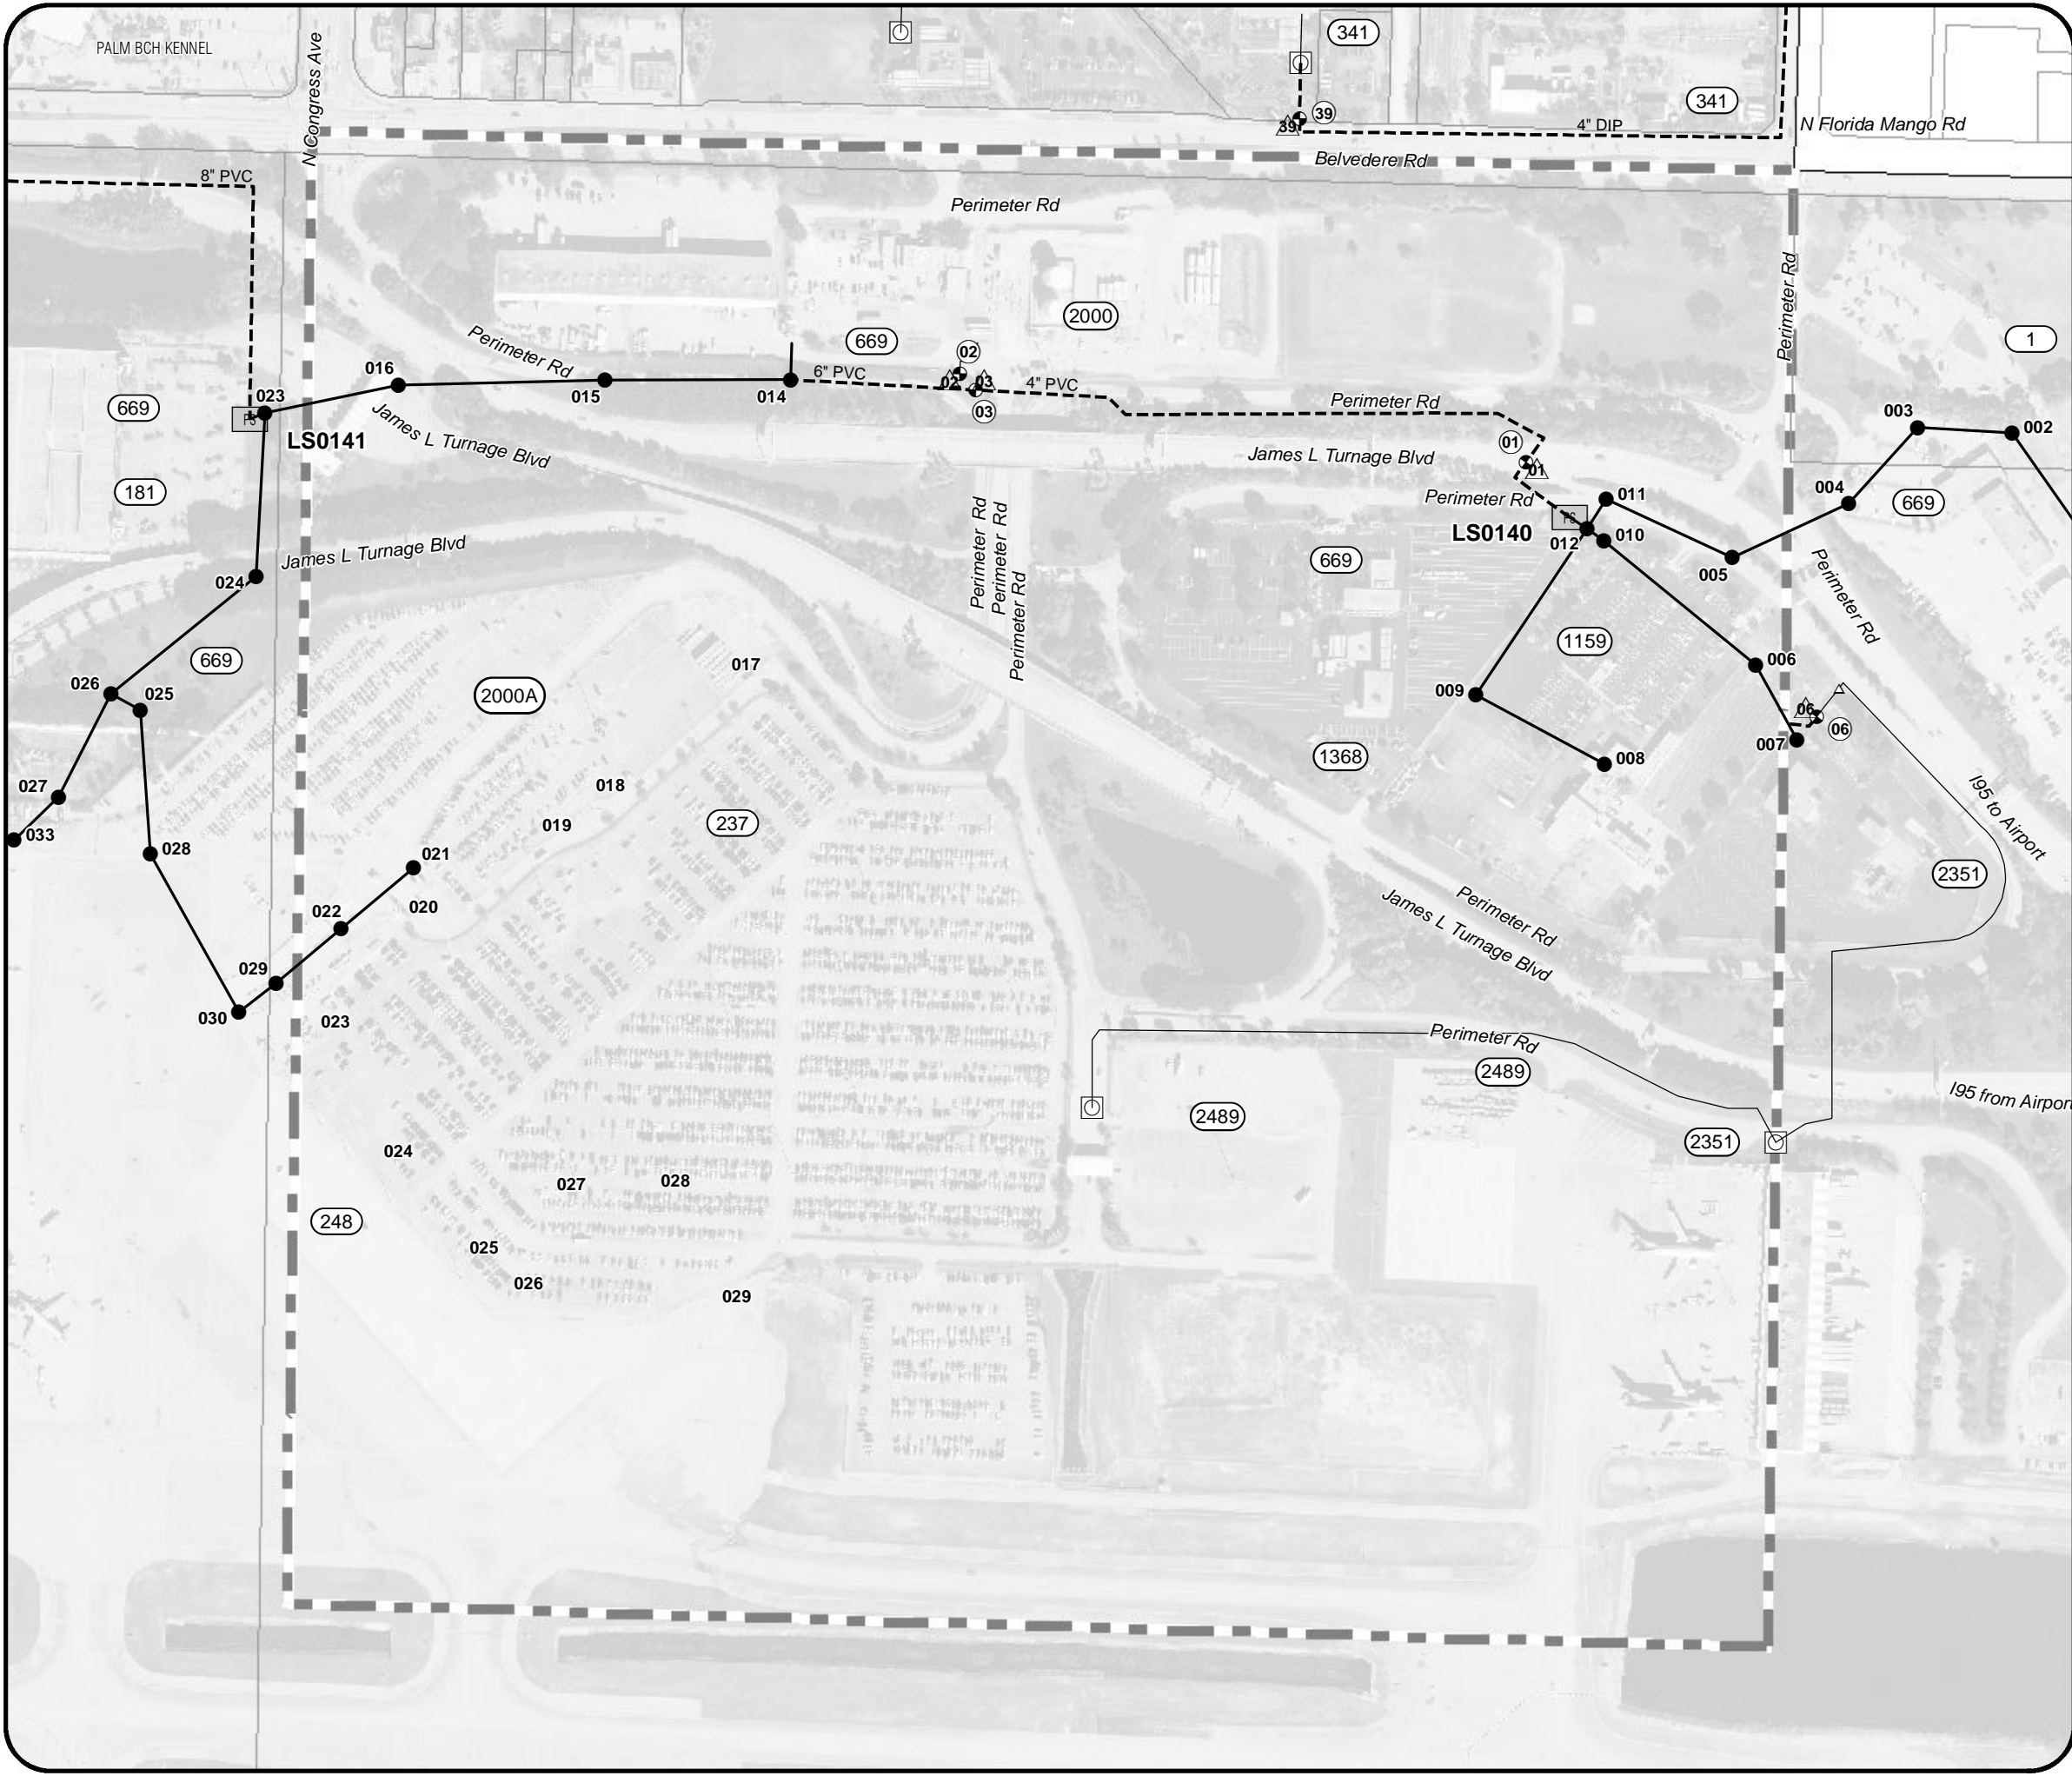






**LEGEND**

- PROPOSED PIPELINE
  - - - EXISTING TO REMAIN
- NOTE: SEE SHEET No.30 FOR DETAILED LEGEND

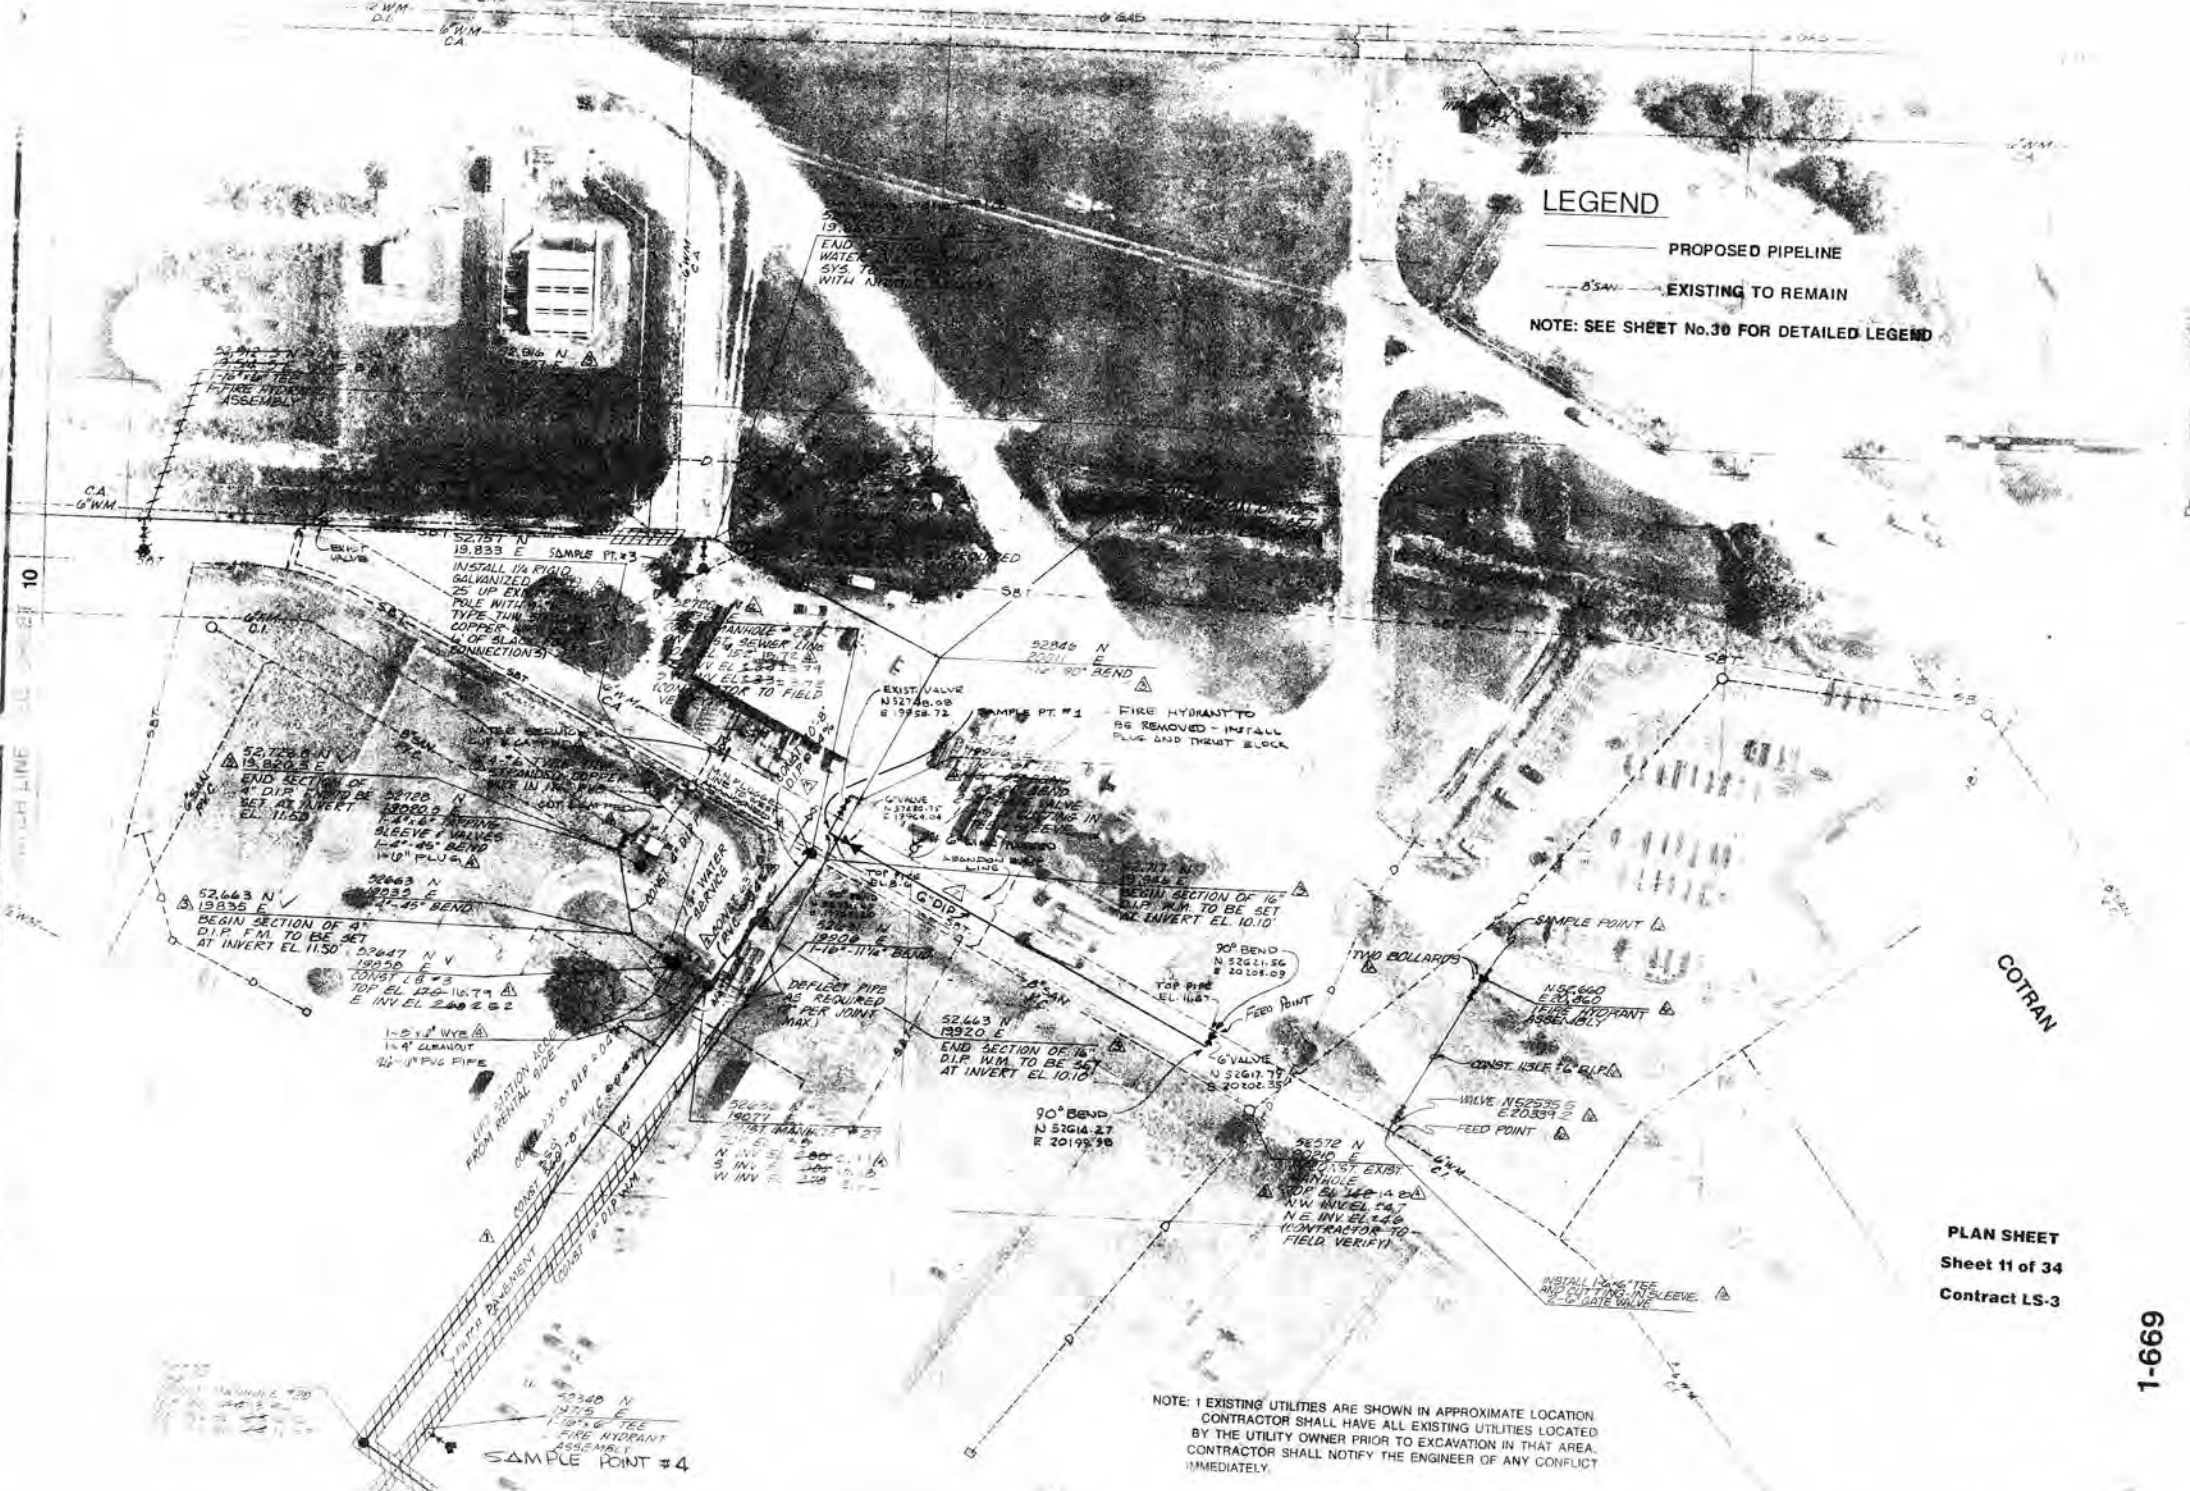

**PLAN SHEET**  
Sheet 11 of 34  
Contract LS-3

1-669

NOTE: 1 EXISTING UTILITIES ARE SHOWN IN APPROXIMATE LOCATION. CONTRACTOR SHALL HAVE ALL EXISTING UTILITIES LOCATED BY THE UTILITY OWNER PRIOR TO EXCAVATION IN THAT AREA. CONTRACTOR SHALL NOTIFY THE ENGINEER OF ANY CONFLICT IMMEDIATELY.